



Rhode Island Airport Corporation

February 1, 2024

**ADDENDUM NO. 004
Request for Proposals (RFP) No. 34620
Airport Terminal Area Public Wi-Fi System at
Rhode Island T. F. Green International Airport (PVD)**

Prospective proposers and all concerned are hereby notified of the following changes in the **Request for Proposals (RFP)** document related to **RFP No. 34620**. These changes shall be incorporated in and shall become an integral part of the contract documents.

Updates to solicitation schedule below:

- (NEW ITEM) RSVP and provide visitor badge info for non-mandatory walk-through By **February 5, 2024** at 12:00pm local time. Please find Visitor Badge application **attached** to this addendum.
- (NEW ITEM) Non-mandatory walk-through = **February 7, 2024** from 11:00am to 1:30pm local time
- Deadline for Proposals are now due **February 23, 2024**

Attachments:

- A. Visitor Badge Application – mandatory for walk through
- B. As-Built Drawings for Wireless Services

Answers to significant questions:

1. Can you provide existing inventory of all existing WLAN environment inclusive of models? Needed to determine how many are EoL. [There are 41 current WAPs, this RFP is meant to replace the existing system.](#)
2. Where do we access Exhibits F-1 for the concourses, food court, terminal and curbside, and F-2 for the Short term lot D in front of the Terminal. [These exhibits are included as part of an addendum. RIAC is scheduling a site visit for those interested parties. RIAC is also including a network map of the current provider in an addendum to this RFP.](#)
3. Is there a network map available for the current wi-fi solution? [RIAC will post a map provided by the current provider in an addendum to this RFP.](#)
4. Can we come onsite to perform a site survey? [RIAC is scheduling a site visit for those interested parties.](#)




Rhode Island Airport Corporation

5. If no onsite survey is available, do you have information for us to perform a predictive model survey allowing us to import your building drawings into our survey software? [RIAC will arrange for a walk-around site survey for those interested parties.](#)
6. Are you getting good WiFi coverage throughout their facility today? [Yes.](#)
7. Can you advise how the public Wi-Fi is managed today? Internally? Externally? [Externally.](#)
8. Do you utilize any kind of NAC applications, if so what? [The current provider offers a web based portal \(not aware if an app version exists\) to access a metrics dashboard that select RIAC staff has credentialed access to.](#)
9. What firewalls are in place today?
 - [Fortigate Model](#)
 - [Fortigate VM64](#)
 - [Fortigate 300-E](#)
 - [Fortigate 300-E](#)
 - [Fortigate 300-E](#)
 - [Fortigate 100-E](#)
 - [Fortigate-100-E](#)
 - [Fortigate 60-E](#)
 - [Fortigate 60E-POE](#)
10. How will the AP's be powered? [TBD by proposers. But currently POE.](#)
11. Do POE switches need to be included in the proposal? [TBD by proposers. But currently POE.](#)
12. Can you provide an inventory of existing LAN environment? [The total number of WAP is in the drawing being provided by the incumbent that will be posted as an addendum.](#)
13. Will the vendor selected have management access to the switches connecting the APs to enable more efficient and automated triage efforts? [The vendor will be replacing the existing switches.](#)
14. Do you know if the existing ethernet cabling plant is CAT5, 5e, or 6? [A mix of 5E and 6, to the best of RIAC's knowledge.](#)
15. Do you know if the current AP mounting locations have ethernet cable service loops available? [Unknown.](#)
16. When was the cabling installed and has it been certified in the past 2 years? [2016-2018 and not re-certified in the last 2 years.](#)
17. What are the average number of users and devices that connect to the wi-fi network today? [Current metrics are as follows: AVG daily user connects = 2000 to 4000, AVG daily data usage \(GB\) = 500 to 1000, AVG minutes per session = 30 to 60, AVG daily sessions = 15000 to 30000](#)
18. Please also identify how this spikes that may occur seasonally or during events. [Airport passenger traffic is seasonal. July, August, and October are typically the 3 busiest months with January, February, and March typically the slowest.](#)
19. Who provides Internet service to the Airport today and what is the bandwidth? [Cox Communications and Verizon. Bandwidth unknown.](#)



Rhode Island Airport Corporation

20. Is there any desire to look at alternate or supplemental Internet circuits as part of this wi-fi project? *To be determined by proposers.*

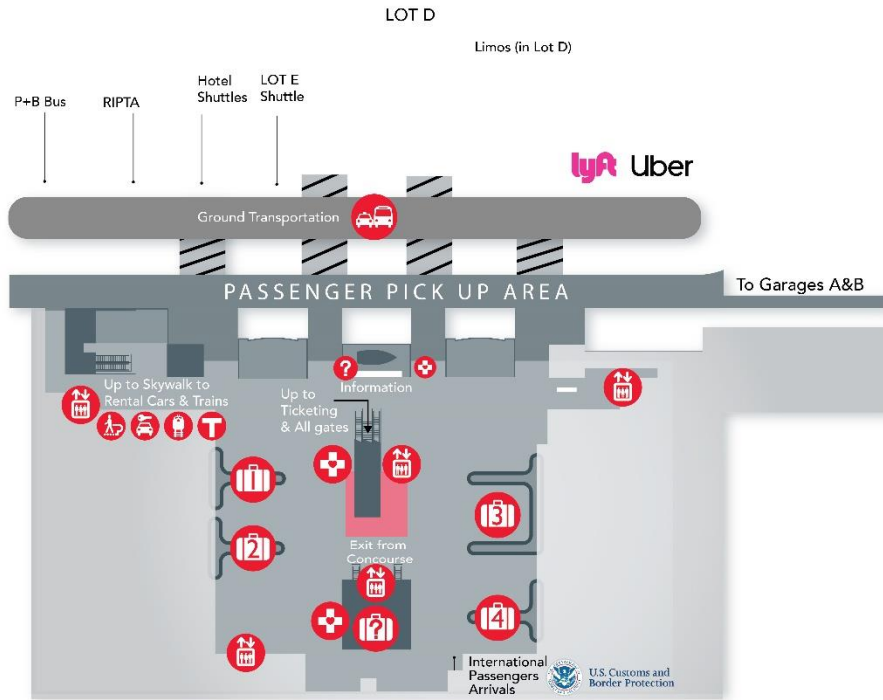






Level 1
Arrivals
Baggage Claim
Ground Transportation

Rhode Island
T. F. Green International Airport

WIRELESS SERVICES T.F. GREEN AIRPORT (PVD)

LEGEND:

-  WIRELESS ACCESS POINT
-  2-POST RACK OR WALL MOUNT RACK
-  CAT6 CABLE PATHWAY FOR ACCESS POINTS AND OUTDOOR BRIDGE RADIOS.
-  MULTI-MODE FIBER PATHWAYS
-  USE EXISTING VERTICAL CONDUIT SLEEVE OR ADD WHERE REQUIRED BETWEEN FLOORS FOR CABLING TO ROOF / WALL MOUNT BRIDGE RADIOS.

ABBREVIATIONS

#	POUND OR NUMBER
AC	AIR CONDITIONING
AP	ACCESS POINT
BLDG	BUILDING
DET	DETAIL
DWG	DRAWING
ELEC	ELECTRICAL
ER	EQUIPMENT ROOM
EXT	EXTERIOR
FT	FOOT
GALV	GALVANIZED
HVAC	HEATING, VENTILATION AND AIR CONDITIONING
IN	INCH
MBPS	MEGABITS PER SECOND
NTS	NOT TO SCALE
OD	OUTSIDE DIAMETER
SS	STAINLESS STEEL
TYP	TYPICAL
UPS	UNINTERRUPTIBLE POWER SUPPLY
WAP	WIRELESS ACCESS POINT

PROJECT PARTICIPANTS

OPERATOR: BOINGO WIRELESS, INC.
10960 WILSHIRE BLVD.,
LOS ANGELES, CA. 90024
23rd FLOOR

TELECOM: -
-
-



APPLICABLE SPECIFICATIONS:

- ABA
- ADA
- BASE EXTERIOR ARCHITECTURE PLAN (BEAP)
- FEDERAL COMMUNICATIONS COMMISSION RULES, PT. 15
- IBC 2009
- NATIONAL ELECTRIC CODE (NFPA 70)
- UNITED FACILITIES CRITERIA (UFC) 1-200-01 (DATED 11/27/07)

VICINITY MAP



SYM	DESCRIPTION	DATE	APPR
	AS-BUILT DRAWINGS	2017-05-18	

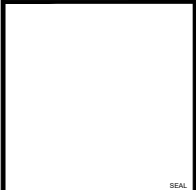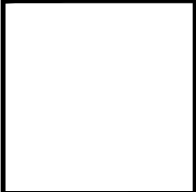



BOINGO WIRELESS, INC.
10960 WILSHIRE BLVD.
23rd FLOOR
LOS ANGELES, CA, 90024

APPROVED	
ACTIVITY	
SATISFACTORY TO	DATE
CAD DESIGNER	EDWARD NARVAEZ
FIELD OPERATIONS MANAGER	DAVID ARMENTO
DIRECTOR	TOM PINCZES

T.F. GREEN AIRPORT (PVD)
WIRELESS SERVICES
WARWICK, RI

TITLE SHEET

SCALE	
PROJECT NO.	000-000
CONSTR. CONTR. NO.	
SHEET	0 OF 00
G1	

1

2

3

4

5

D

C

B

A

D

C


B

A

DRAWING INDEX

SHEET	TITLE	DESCRIPTION
G1	TITLE SHEET	
G2	DRAWING INDEX	
T1.0	TYPICAL WIRELESS INFRASTRUCTURE DIAGRAM	
FLOOR PLANS		
T1.1A	FIRST FLOOR NORTH CONCOURSE	GATES 9-22
T1.1B	FIRST FLOOR CENTER CONCOURSE	
T1.1C	FIRST FLOOR SOUTH CONCOURSE	GATES 1-8
T1.2A	SECOND FLOOR NORTH CONCOURSE	
T1.2B	SECOND FLOOR CENTER CONCOURSE	
T1.2C	SECOND FLOOR SOUTH CONCOURSE	
EQUIPMENT INSTALLATION DETAILS		
T3.0	TELCO ROOM DETAILS	
T4.1	CISCO AIRONET INDOOR WAP CEILING MOUNT DETAIL	
T4.2	CABLE ROUTING DETAIL	
T4.3	CABLE MOUNTING DETAILS	
T4.4	CONDUIT MOUNTING DETAILS	
T4.5	CABLE PENETRATION DETAILS	

SYMBOL	DESCRIPTION	DATE	APPROVED
	AS-BUILT DRAWINGS	2017-05-18	

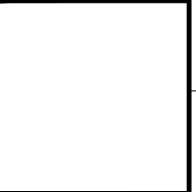


boingo

BOINGO WIRELESS, INC.
 10960 WILSHIRE BLVD.
 23rd FLOOR
 LOS ANGELES, CA, 90024

APPROVED

ACTIVITY

SATISFACTORY TO DATE

CAD DESIGNER

EDWARD NARVAEZ

FIELD OPERATIONS MANAGER

DAVID ARMENTO

DIRECTOR

TOM PINCZES

T.F. GREEN AIRPORT (PVD) WIRELESS SERVICES WARWICK, RI	DRAWING INDEX
--	---------------

SCALE:
 PROJECT NO.: 000-000
 CONSTR. CONTR. NO.

SHEET 0 OF 00

G2

1

2

3

4

5

1

2

3

4

5

D

C

B

A

D


C

B

A

GENERAL NOTES:

1. SELECTED EQUIPMENT ROOM IS BUILDING SPECIFIC AND IS IDENTIFIED ON THE BUILDING INSTALLATION DRAWINGS.
2. DIAGRAM IS TYPICAL FOR BUILDINGS WITH THREE FLOORS.
3. BUILDINGS WITH A CENTRAL UTILITY GALLEY HAVE A CAT6 CABLE PATHWAY PER FLOOR SUPPORTED ON J-HOOKS.
4. BUILDINGS WITH NO CENTRAL UTILITY GALLEY HAVE CAT6 CABLE PATHWAYS INSIDE SOFFIT OR CONDUIT/RACEWAY ALONG EACH EXTERIOR SIDE.
5. PRE-WIRED TYPE BUILDINGS UTILIZE EXISTING CAT6 IN ROOMS IF ALLOWED. CONTRACTOR TO INSTALL NEW CONDUIT AND CAT6 CABLE FOR OUTDOOR RADIOS AND NON-PRE-WIRED ROOMS; NEW CONDUIT AND CAT6 CABLE SHALL BE USED FOR ALL ACCESS POINTS IF THE EXISTING PRE-WIRE IS UNUSABLE PER SITE INSTRUCTIONS.

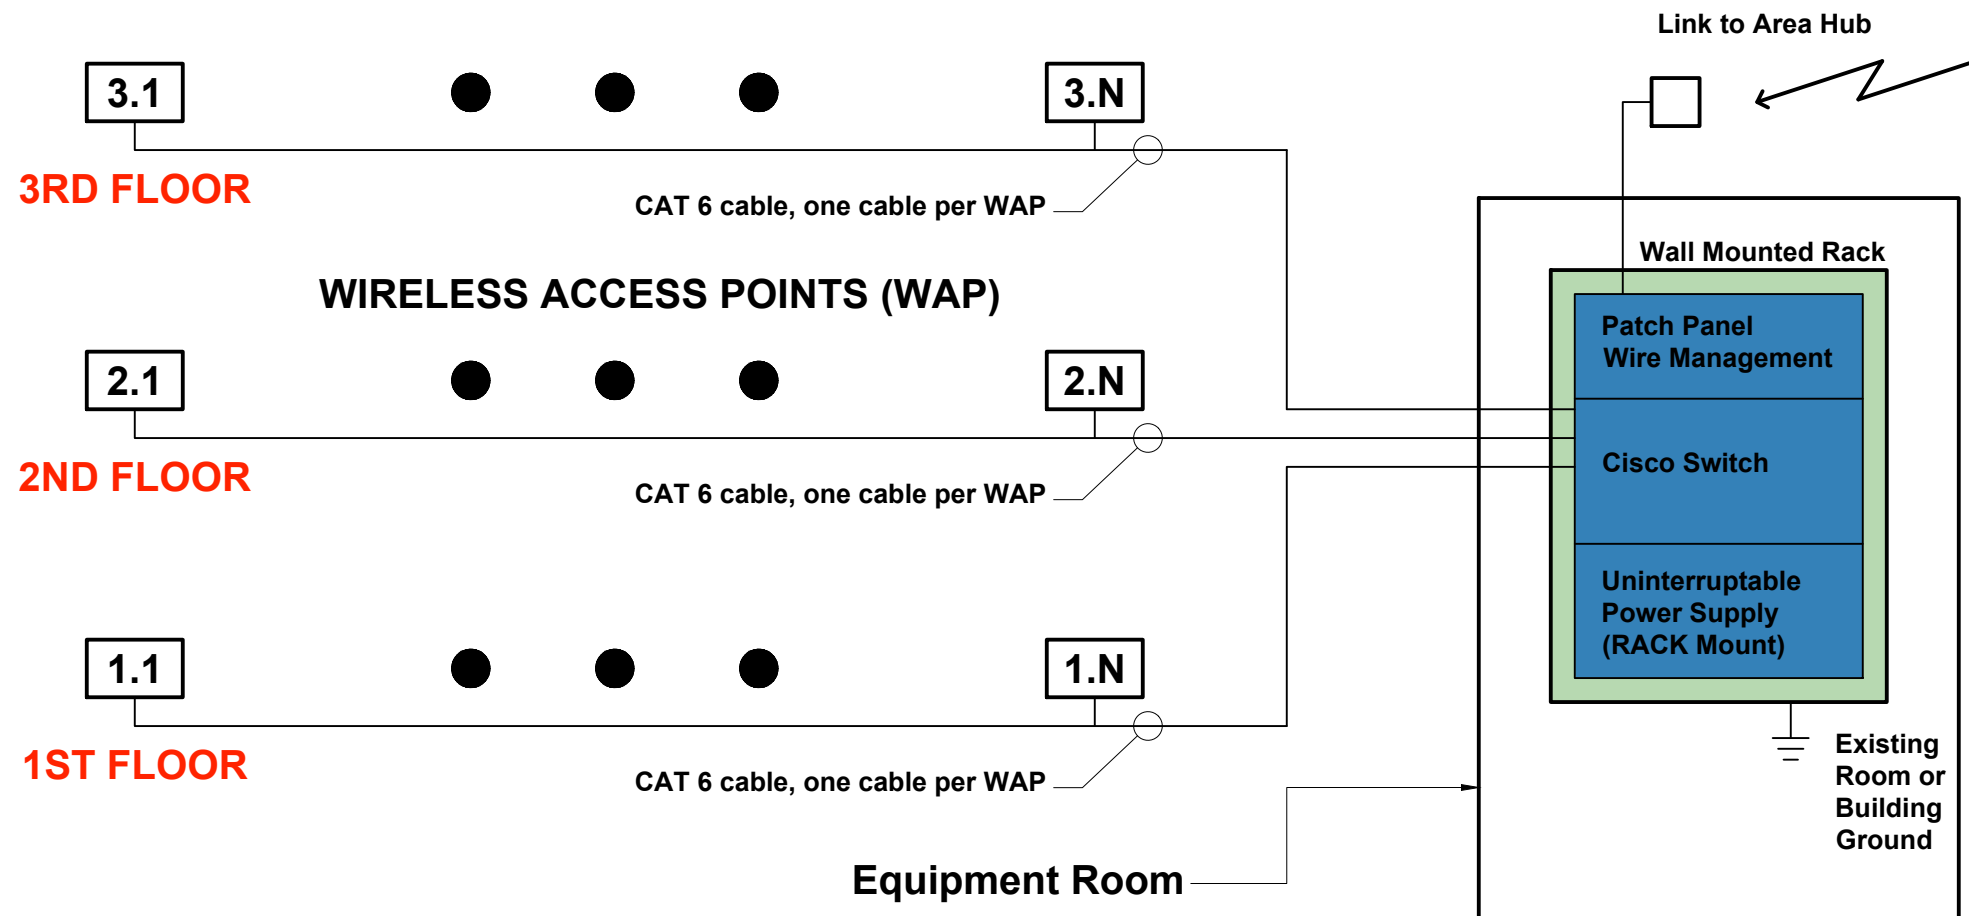

TYPICAL WIRELESS INFRASTRUCTURE DIAGRAM

SYM	DESCRIPTION	DATE	APPR
	AS-BUILT DRAWINGS	2017-05-18	

--

--

boingo

BOINGO WIRELESS, INC.
10960 WILSHIRE BLVD.
23rd FLOOR
LOS ANGELES, CA, 90024

APPROVED

ACTIVITY

SATISFACTORY TO DATE

CAD DESIGNER	EDWARD NARVAEZ
--------------	----------------

FIELD OPERATIONS MANAGER	DAVID ARMENTO
--------------------------	---------------

DIRECTOR	TOM PINCZES
----------	-------------

T.F. GREEN AIRPORT (PVD)
WIRELESS SERVICES
WARWICK, RI

TYPICAL WIRELESS INFRASTRUCTURE DIAGRAM

SCALE

PROJECT NO.	000-000
CONSTR. CONTR. NO.	

SHEET	0	OF	00
-------	---	----	----

T1.0

DRAWING REVISION: 24 May 2017

1

2

3

4

5

1

2

3

4

5

D

C

B

A

D

C


B

A

FIRST FLOOR NORTH CONCOURSE 1 WAP's

GENERAL NOTES:


- BUILDING TYPE: **DROP-CEILING**
 - NEWLY INSTALLED CAT6 WILL BE USED TO CONNECT ALL WAP'S.
 - AP'S TO BE MOUNTED TO DROP CEILING TRACK USING MOUNTING BRACKETS SUPPLIED BY MANUFACTURER. AP'S MAY BE MOVED UP TO TWO TILES (4') IN EITHER DIRECTION IN ORDER TO ACCOUNT FOR CEILING OBSTRUCTIONS SUCH AS LIGHT FIXTURES, EXIT SIGNS, HVAC DUCTS, AND SO FORTH.
- TOTAL WAP QUANTITY: 41
ACCESS POINTS: 10 (1ST FLOOR)
ACCESS POINTS: 31 (2ND FLOOR)
- ALL INDOOR WAP'S ARE CISCO C2702i UNLESS OTHERWISE NOTED.
- PROVIDE 12 VDC POWER TO THE WIRELESS ACCESS POINTS VIA CAT6 SIGNAL CABLE.
- (1) CAT6 CABLE SHALL BE ROUTED TO EACH ACCESS POINT LOCATION.
- IDENTIFY WAP & CAT6 CABLES AS A - B - C - D
WHERE A IS THE SITE ID
WHERE B IS THE ID
WHERE C IS THE SWITCH
WHERE D IS THE WAP

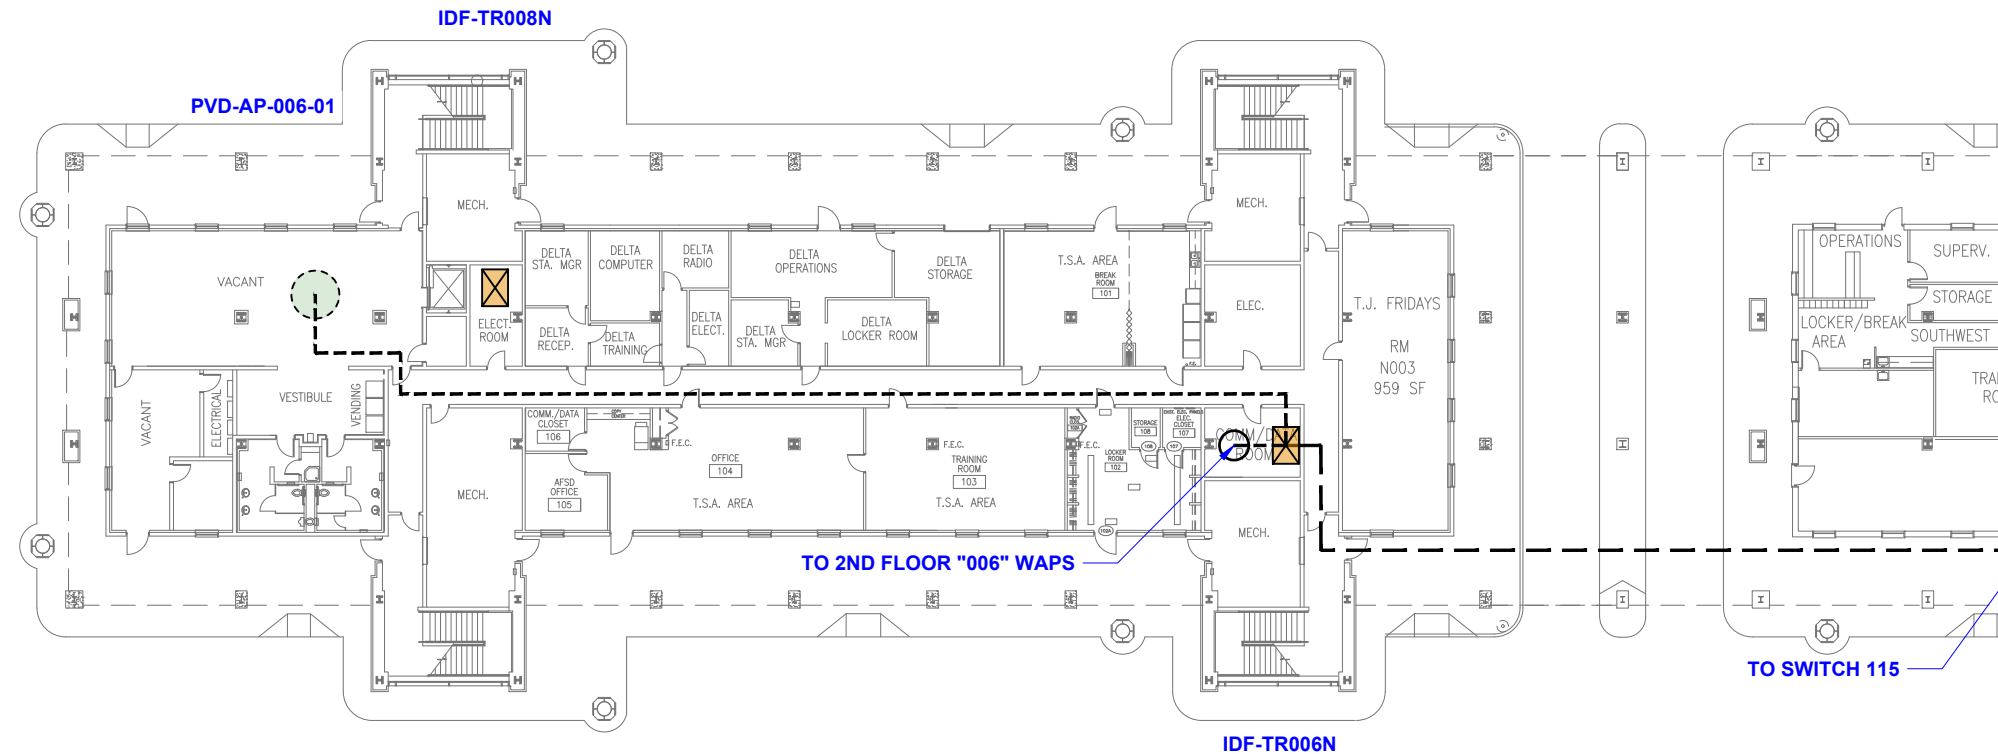

FIRST FLOOR NORTH CONCOURSE - WIRELESS SIGNAL PLAN GATES 16 - 22

LEGEND:

- WIRELESS ACCESS POINT
- 2-POST RACK OR WALL MOUNT RACK
- CAT6 CABLE PATHWAY FOR ACCESS POINTS AND OUTDOOR BRIDGE RADIOS.
- MULTI-MODE FIBER PATHWAYS
- USE EXISTING VERTICAL CONDUIT SLEEVE OR ADD WHERE REQUIRED BETWEEN FLOORS FOR CABLING TO ROOF / WALL MOUNT BRIDGE RADIOS.

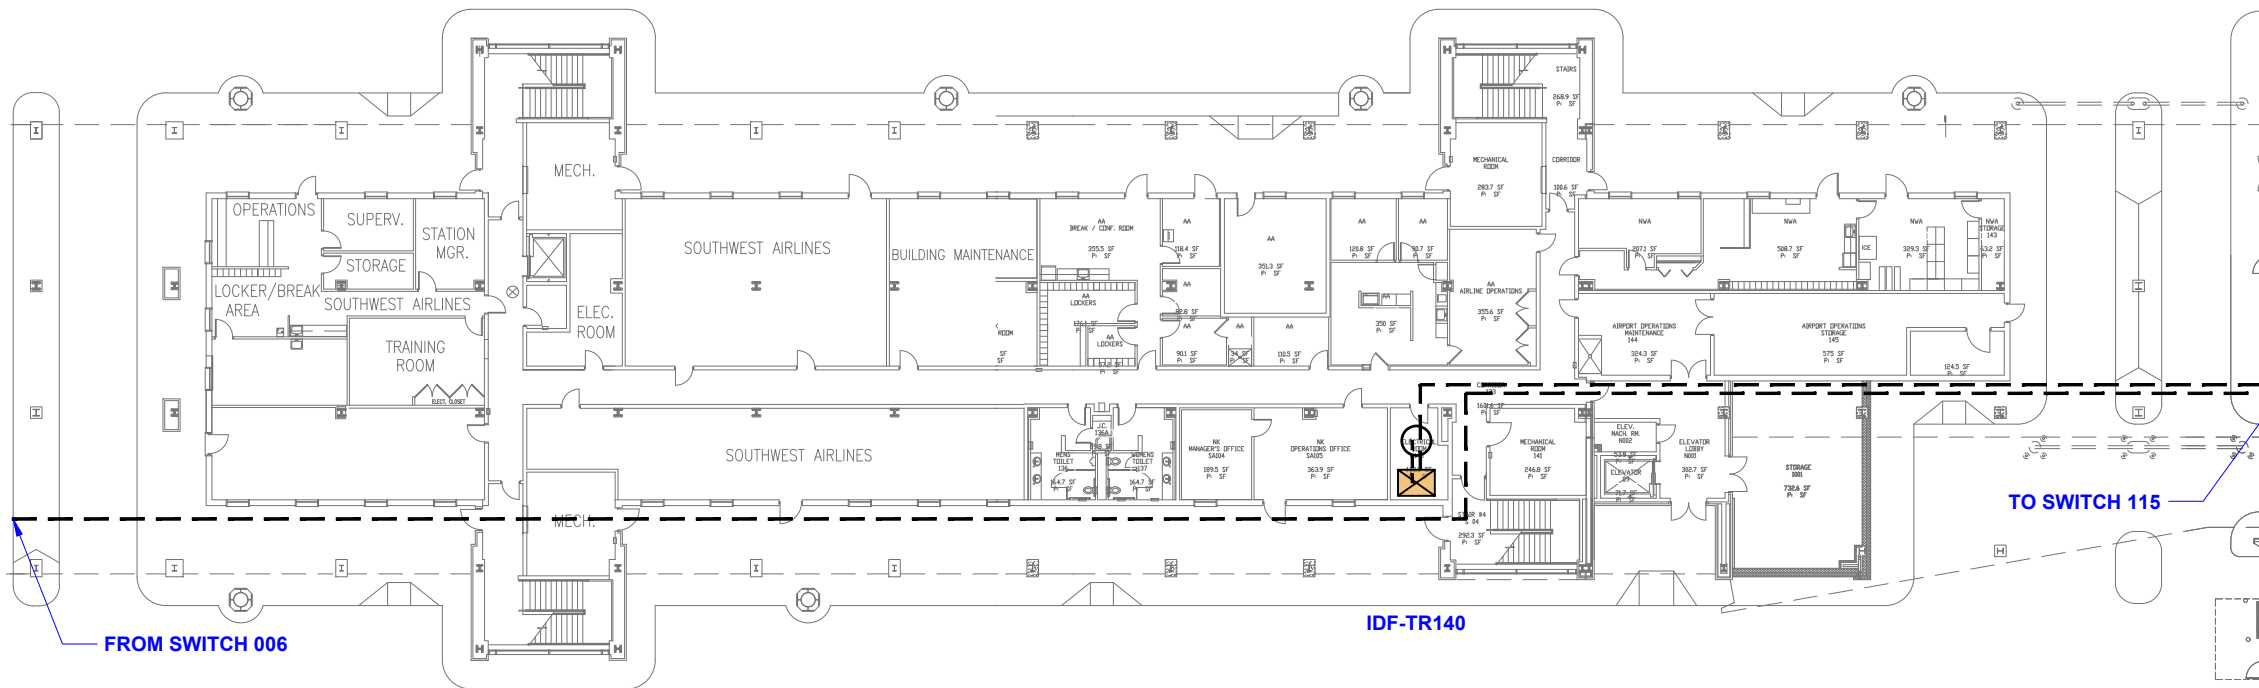

FIRST FLOOR NORTH CONCOURSE - WIRELESS SIGNAL PLAN GATES 9 - 15

SYMBOL	DESCRIPTION	DATE	APPR
	AS-BUILT DRAWINGS	2017-05-18	

APPROVED	
----------	--

ACTIVITY	
----------	--

BOINGO WIRELESS, INC. 10960 WILSHIRE BLVD. 23rd FLOOR LOS ANGELES, CA, 90024	

APPROVED	
----------	--

CAD DESIGNER	EDWARD NARVAEZ
FIELD OPERATIONS MANAGER	DAVID ARMENTO
DIRECTOR	TOM PINCZES

T.F. GREEN AIRPORT (PVD) WIRELESS SERVICES WARWICK, RI	FIRST FLOOR NORTH CONCOURSE GATES 9-22
--	---

SCALE:	
PROJECT NO.:	000-000
CONSTR. CONTR. NO.:	
SHEET	0 OF 00
T1.1A	

1

2

3

4


5

D

C

B

A

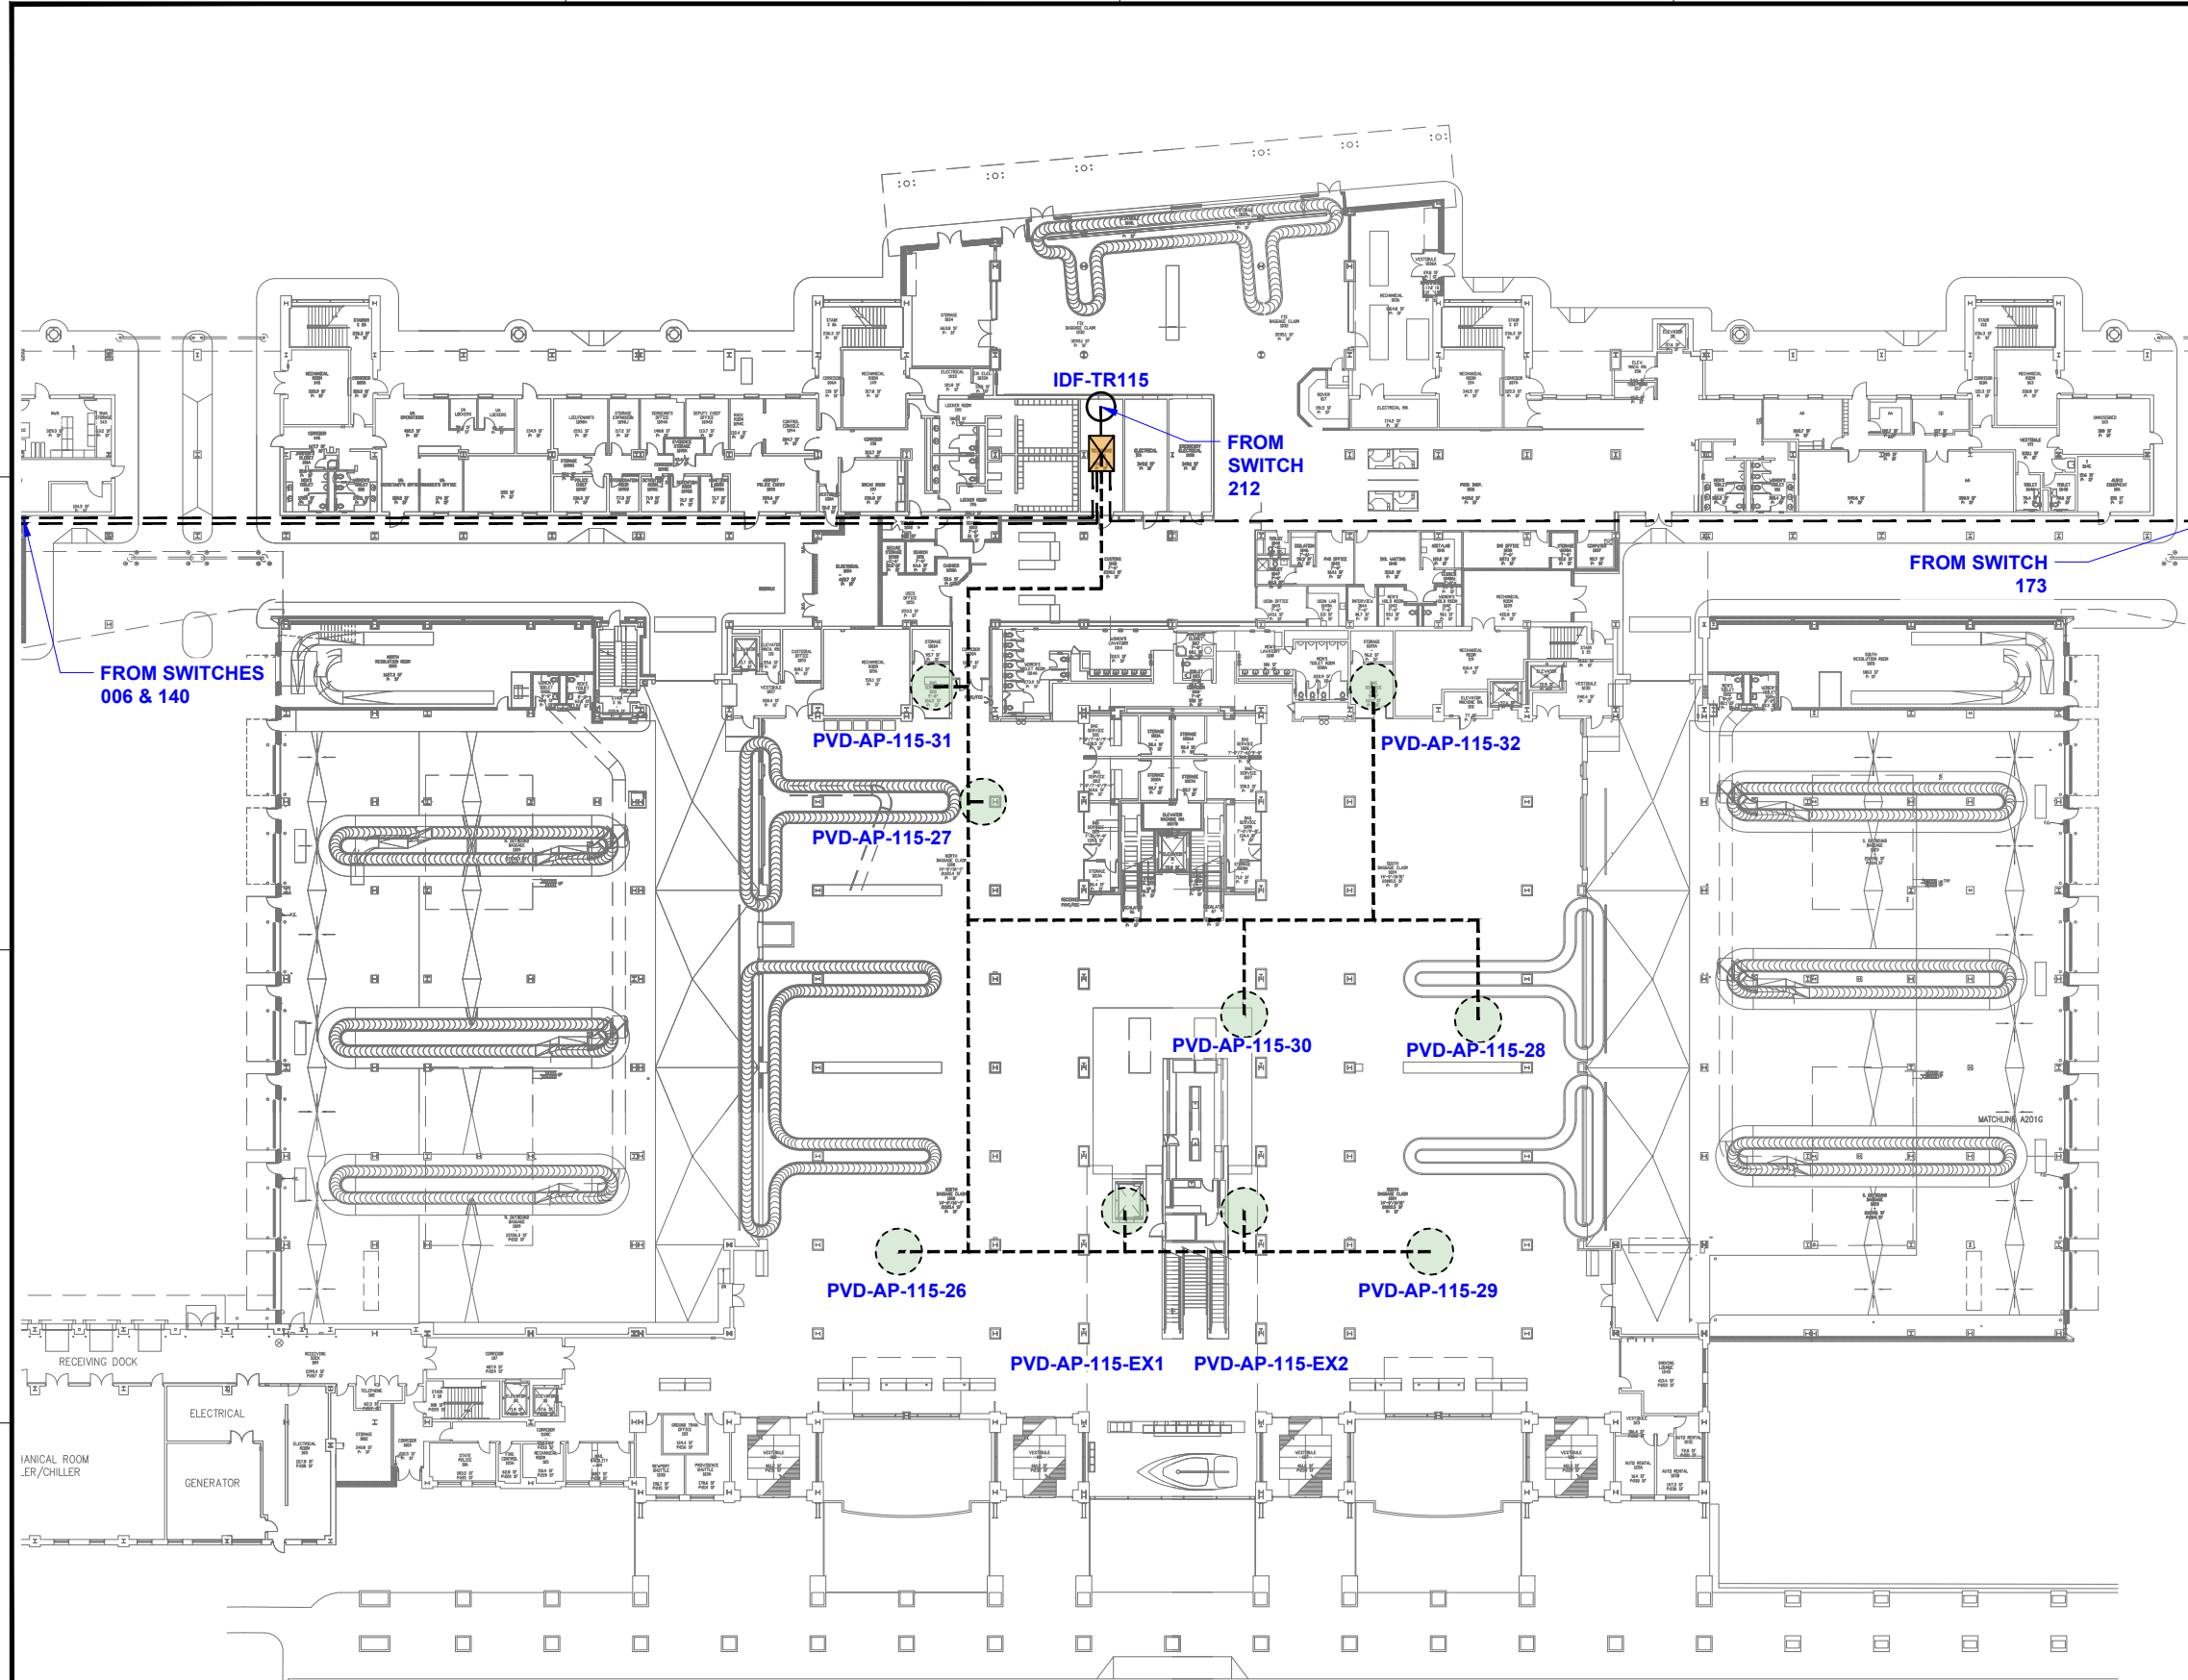

**FIRST FLOOR CENTER CONCOURSE
9 WAP's**

GENERAL NOTES:

- BUILDING TYPE: **DROP-CEILING**
 - NEWLY INSTALLED CAT6 WILL BE USED TO CONNECT ALL WAP'S.
 - AP'S TO BE MOUNTED TO DROP CEILING TRACK USING MOUNTING BRACKETS SUPPLIED BY MANUFACTURER. AP'S MAY BE MOVED UP TO TWO TILES (4') IN EITHER DIRECTION IN ORDER TO ACCOUNT FOR CEILING OBSTRUCTIONS SUCH AS LIGHT FIXTURES, EXIT SIGNS, HVAC DUCTS, AND SO FORTH.
- TOTAL WAP QUANTITY: 41
ACCESS POINTS: 10 (1ST FLOOR)
ACCESS POINTS: 31 (2ND FLOOR)
- ALL INDOOR WAP'S ARE CISCO C2702i UNLESS OTHERWISE NOTED.
- PROVIDE 12 VDC POWER TO THE WIRELESS ACCESS POINTS VIA CAT6 SIGNAL CABLE.
- (1) CAT6 CABLE SHALL BE ROUTED TO EACH ACCESS POINT LOCATION.
- IDENTIFY WAP & CAT6 CABLES AS A - B - C - D
WHERE A IS THE SITE ID
WHERE B IS THE ID
WHERE C IS THE SWITCH
WHERE D IS THE WAP

LEGEND:

- WIRELESS ACCESS POINT
- 2-POST RACK OR WALL MOUNT RACK
- CAT6 CABLE PATHWAY FOR ACCESS POINTS AND OUTDOOR BRIDGE RADIOS.
- MULTI-MODE FIBER PATHWAYS
- USE EXISTING VERTICAL CONDUIT SLEEVE OR ADD WHERE REQUIRED BETWEEN FLOORS FOR CABLING TO ROOF / WALL MOUNT BRIDGE RADIOS.

FIRST FLOOR CENTER CONCOURSE - WIRELESS SIGNAL PLAN

SYMBOL DESCRIPTION	DATE	APPROVED
AS-BUILT DRAWINGS	2017-05-18	

--	--	--

--	--	--

boingo

BOINGO WIRELESS, INC.
10960 WILSHIRE BLVD.
23rd FLOOR
LOS ANGELES, CA, 90024

APPROVED	
ACTIVITY	
SATISFACTORY TO DATE	
CAD DESIGNER	EDWARD NARVAEZ
FIELD OPERATIONS MANAGER	DAVID ARMENTO
DIRECTOR	TOM PINCZES

T.F. GREEN AIRPORT (PVD)
WIRELESS SERVICES
WARWICK, RI

FIRST FLOOR CENTER CONCOURSE

SCALE	
PROJECT NO.	000-000
CONSTR. CONTR. NO.	
SHEET	0 OF 00
T1.1B	


1

2

3

4

5

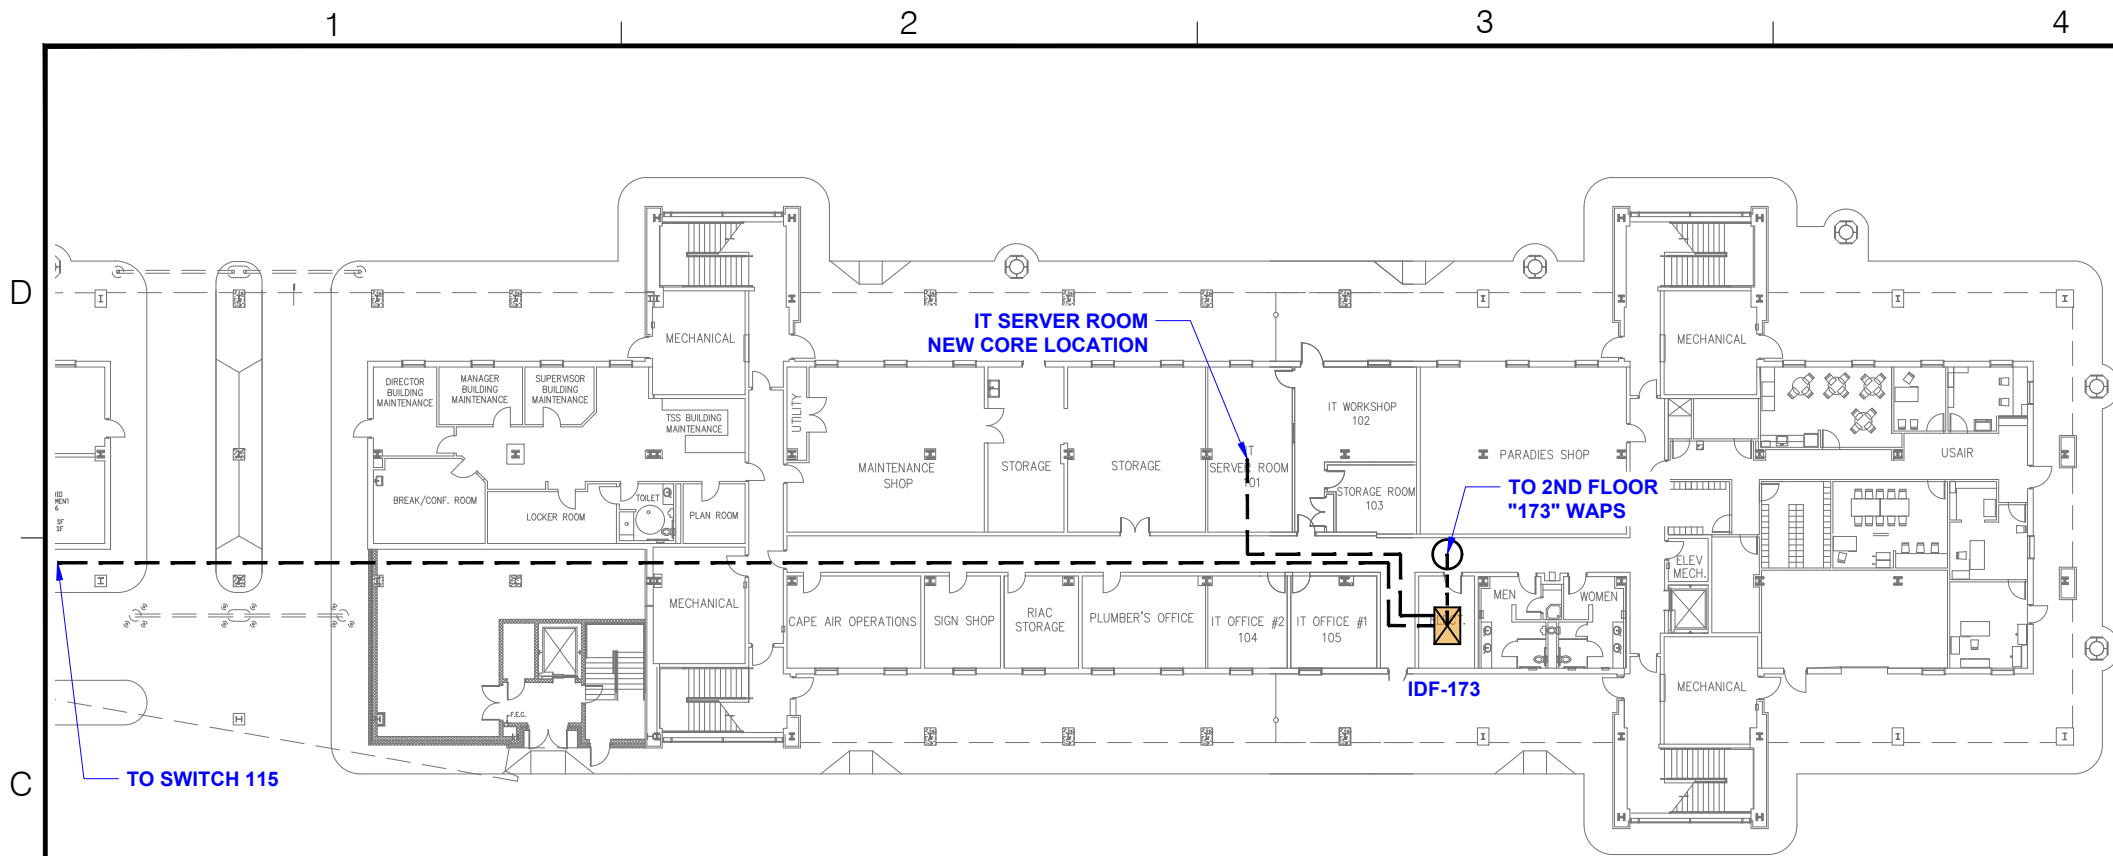

FIRST FLOOR SOUTH CONCOURSE - WIRELESS SIGNAL PLAN GATES 1 - 8

**FIRST FLOOR SOUTH CONCOURSE
0 WAP's**

GENERAL NOTES:

- BUILDING TYPE: **DROP-CEILING**
 - NEWLY INSTALLED CAT6 WILL BE USED TO CONNECT ALL WAP'S.**
 - AP'S TO BE MOUNTED TO DROP CEILING TRACK USING MOUNTING BRACKETS SUPPLIED BY MANUFACTURER. AP'S MAY BE MOVED UP TO TWO TILES (4') IN EITHER DIRECTION IN ORDER TO ACCOUNT FOR CEILING OBSTRUCTIONS SUCH AS LIGHT FIXTURES, EXIT SIGNS, HVAC DUCTS, AND SO FORTH.
- TOTAL WAP QUANTITY: 41
ACCESS POINTS: 10 (1ST FLOOR)
ACCESS POINTS: 31 (2ND FLOOR)
- ALL INDOOR WAP'S ARE CISCO C2702i UNLESS OTHERWISE NOTED.
- PROVIDE 12 VDC POWER TO THE WIRELESS ACCESS POINTS VIA CAT6 SIGNAL CABLE.
- (1) CAT6 CABLE SHALL BE ROUTED TO EACH ACCESS POINT LOCATION.
- IDENTIFY WAP & CAT6 CABLES AS
A - B - C - D
WHERE A IS THE SITE ID
WHERE B IS THE ID
WHERE C IS THE SWITCH
WHERE D IS THE WAP

LEGEND:

- WIRELESS ACCESS POINT
- 2-POST RACK OR WALL MOUNT RACK
- CAT6 CABLE PATHWAY FOR ACCESS POINTS AND OUTDOOR BRIDGE RADIOS.
- MULTI-MODE FIBER PATHWAYS
- USE EXISTING VERTICAL CONDUIT SLEEVE OR ADD WHERE REQUIRED BETWEEN FLOORS FOR CABLING TO ROOF / WALL MOUNT BRIDGE RADIOS.

SYMBOL DESCRIPTION	DATE	APPR
AS-BUILT DRAWINGS	2017-05-18	

--

--

BOINGO WIRELESS, INC.
10960 WILSHIRE BLVD.
23rd FLOOR
LOS ANGELES, CA, 90024


APPROVED
ACTIVITY
SATISFACTORY TO DATE

CAD DESIGNER EDWARD NARVAEZ
FIELD OPERATIONS MANAGER DAVID ARMENTO
DIRECTOR TOM PINCZES


T.F. GREEN AIRPORT (PVD)
WIRELESS SERVICES
WARWICK, RI

FIRST FLOOR SOUTH CONCOURSE
GATES 1-8

SCALE
PROJECT NO.: 000-000
CONSTR. CONTR. NO.
SHEET 0 OF 00

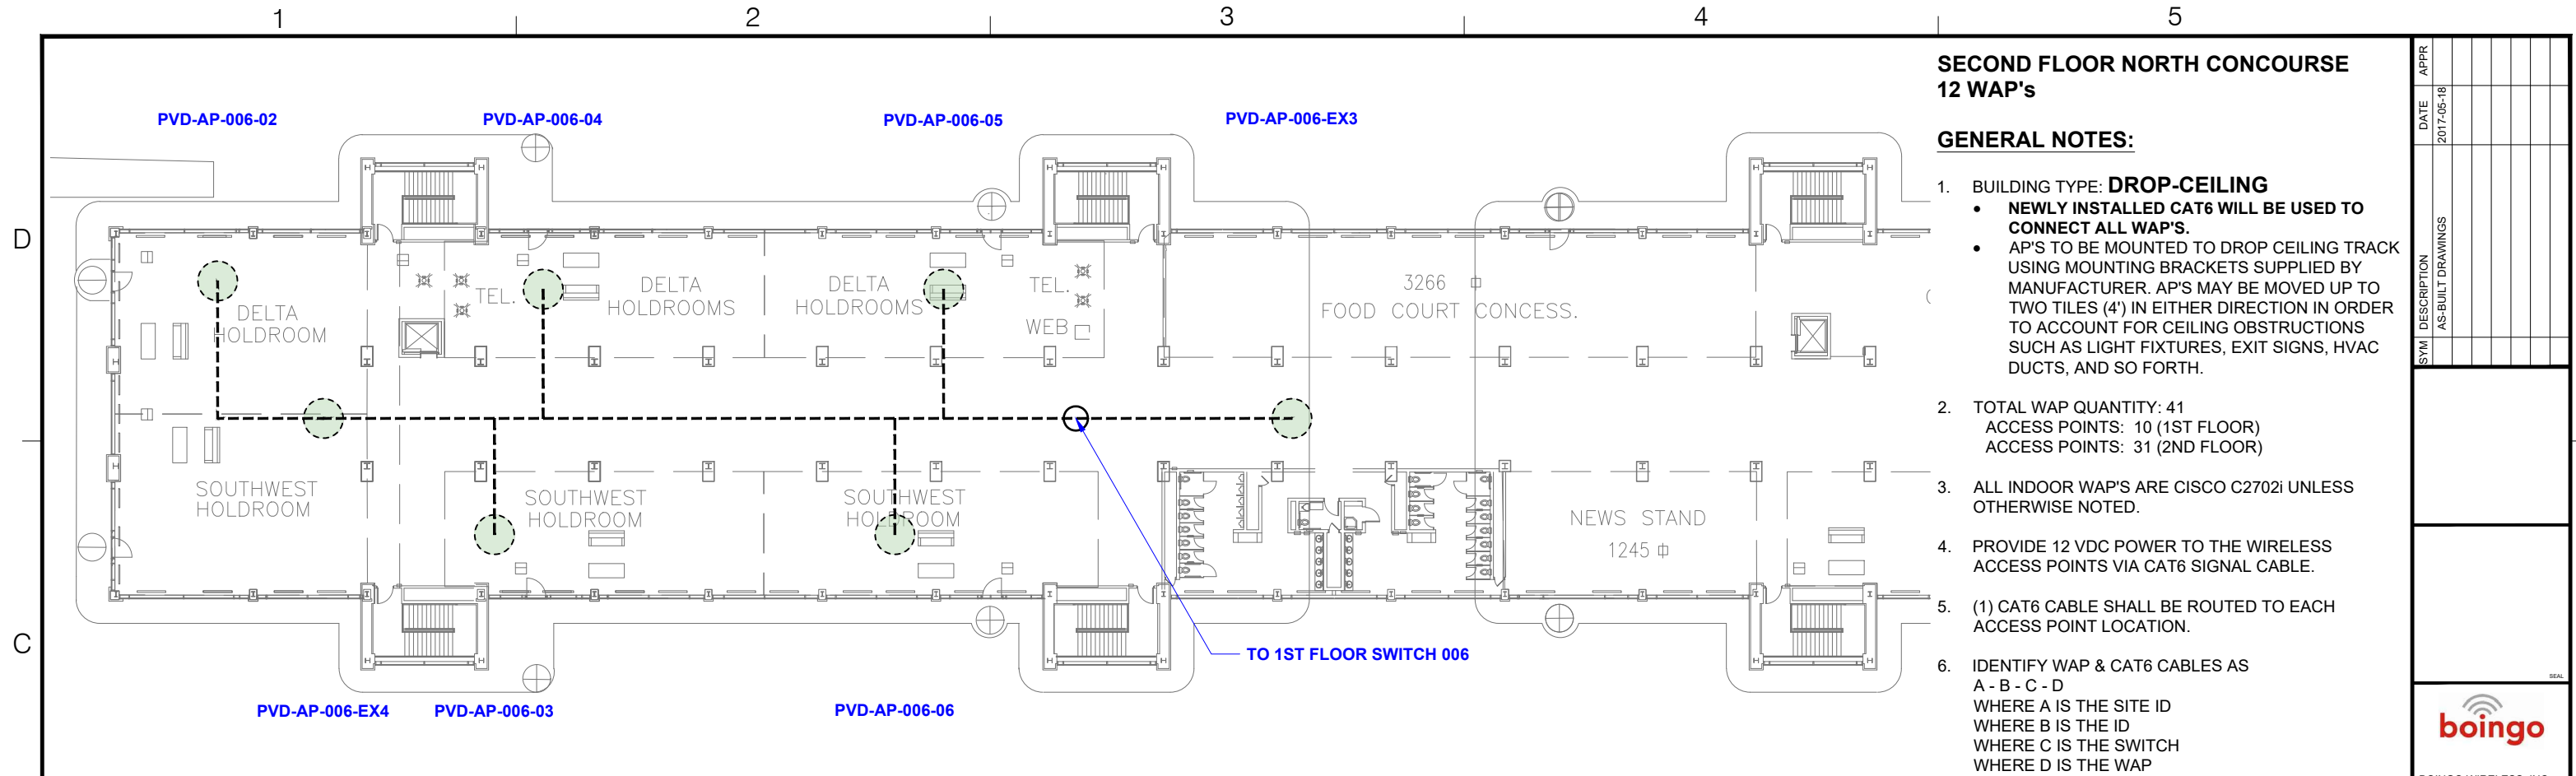

SECOND FLOOR NORTH CONCOURSE - WIRELESS SIGNAL PLAN

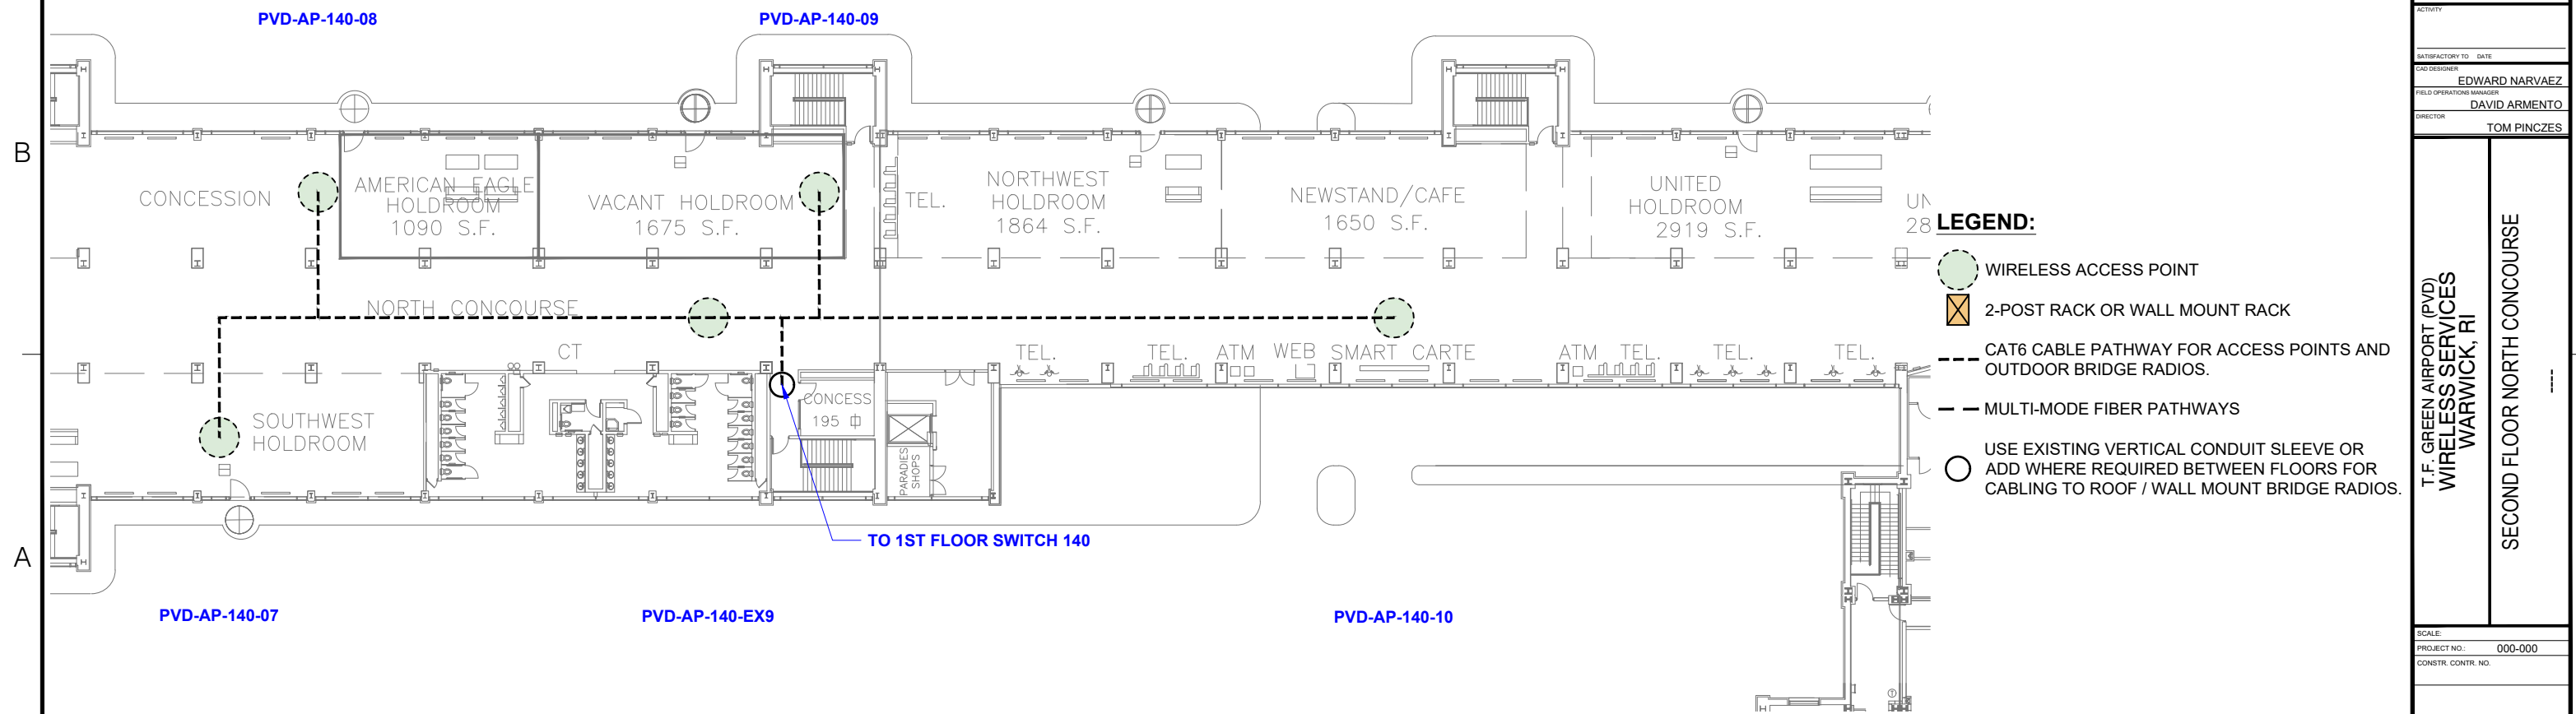

SECOND FLOOR NORTH CONCOURSE - WIRELESS SIGNAL PLAN

SYMBOL DESCRIPTION	AS-BUILT DRAWINGS
DATE	2017-05-18
APPROVED	
ACTIVITY	
SATISFACTORY TO	DATE
CAD DESIGNER	EDWARD NARVAEZ
FIELD OPERATIONS MANAGER	DAVID ARMENTO
DIRECTOR	TOM PINCZES
T.F. GREEN AIRPORT (PVD) WIRELESS SERVICES WARWICK, RI	
SECOND FLOOR NORTH CONCOURSE	
SCALE	
PROJECT NO.	000-000
CONSTR. CONTR. NO.	
SHEET	0 OF 00
T1.2A	
DRAWING REVISION: 24 May 2017	


1

2

3

4

5

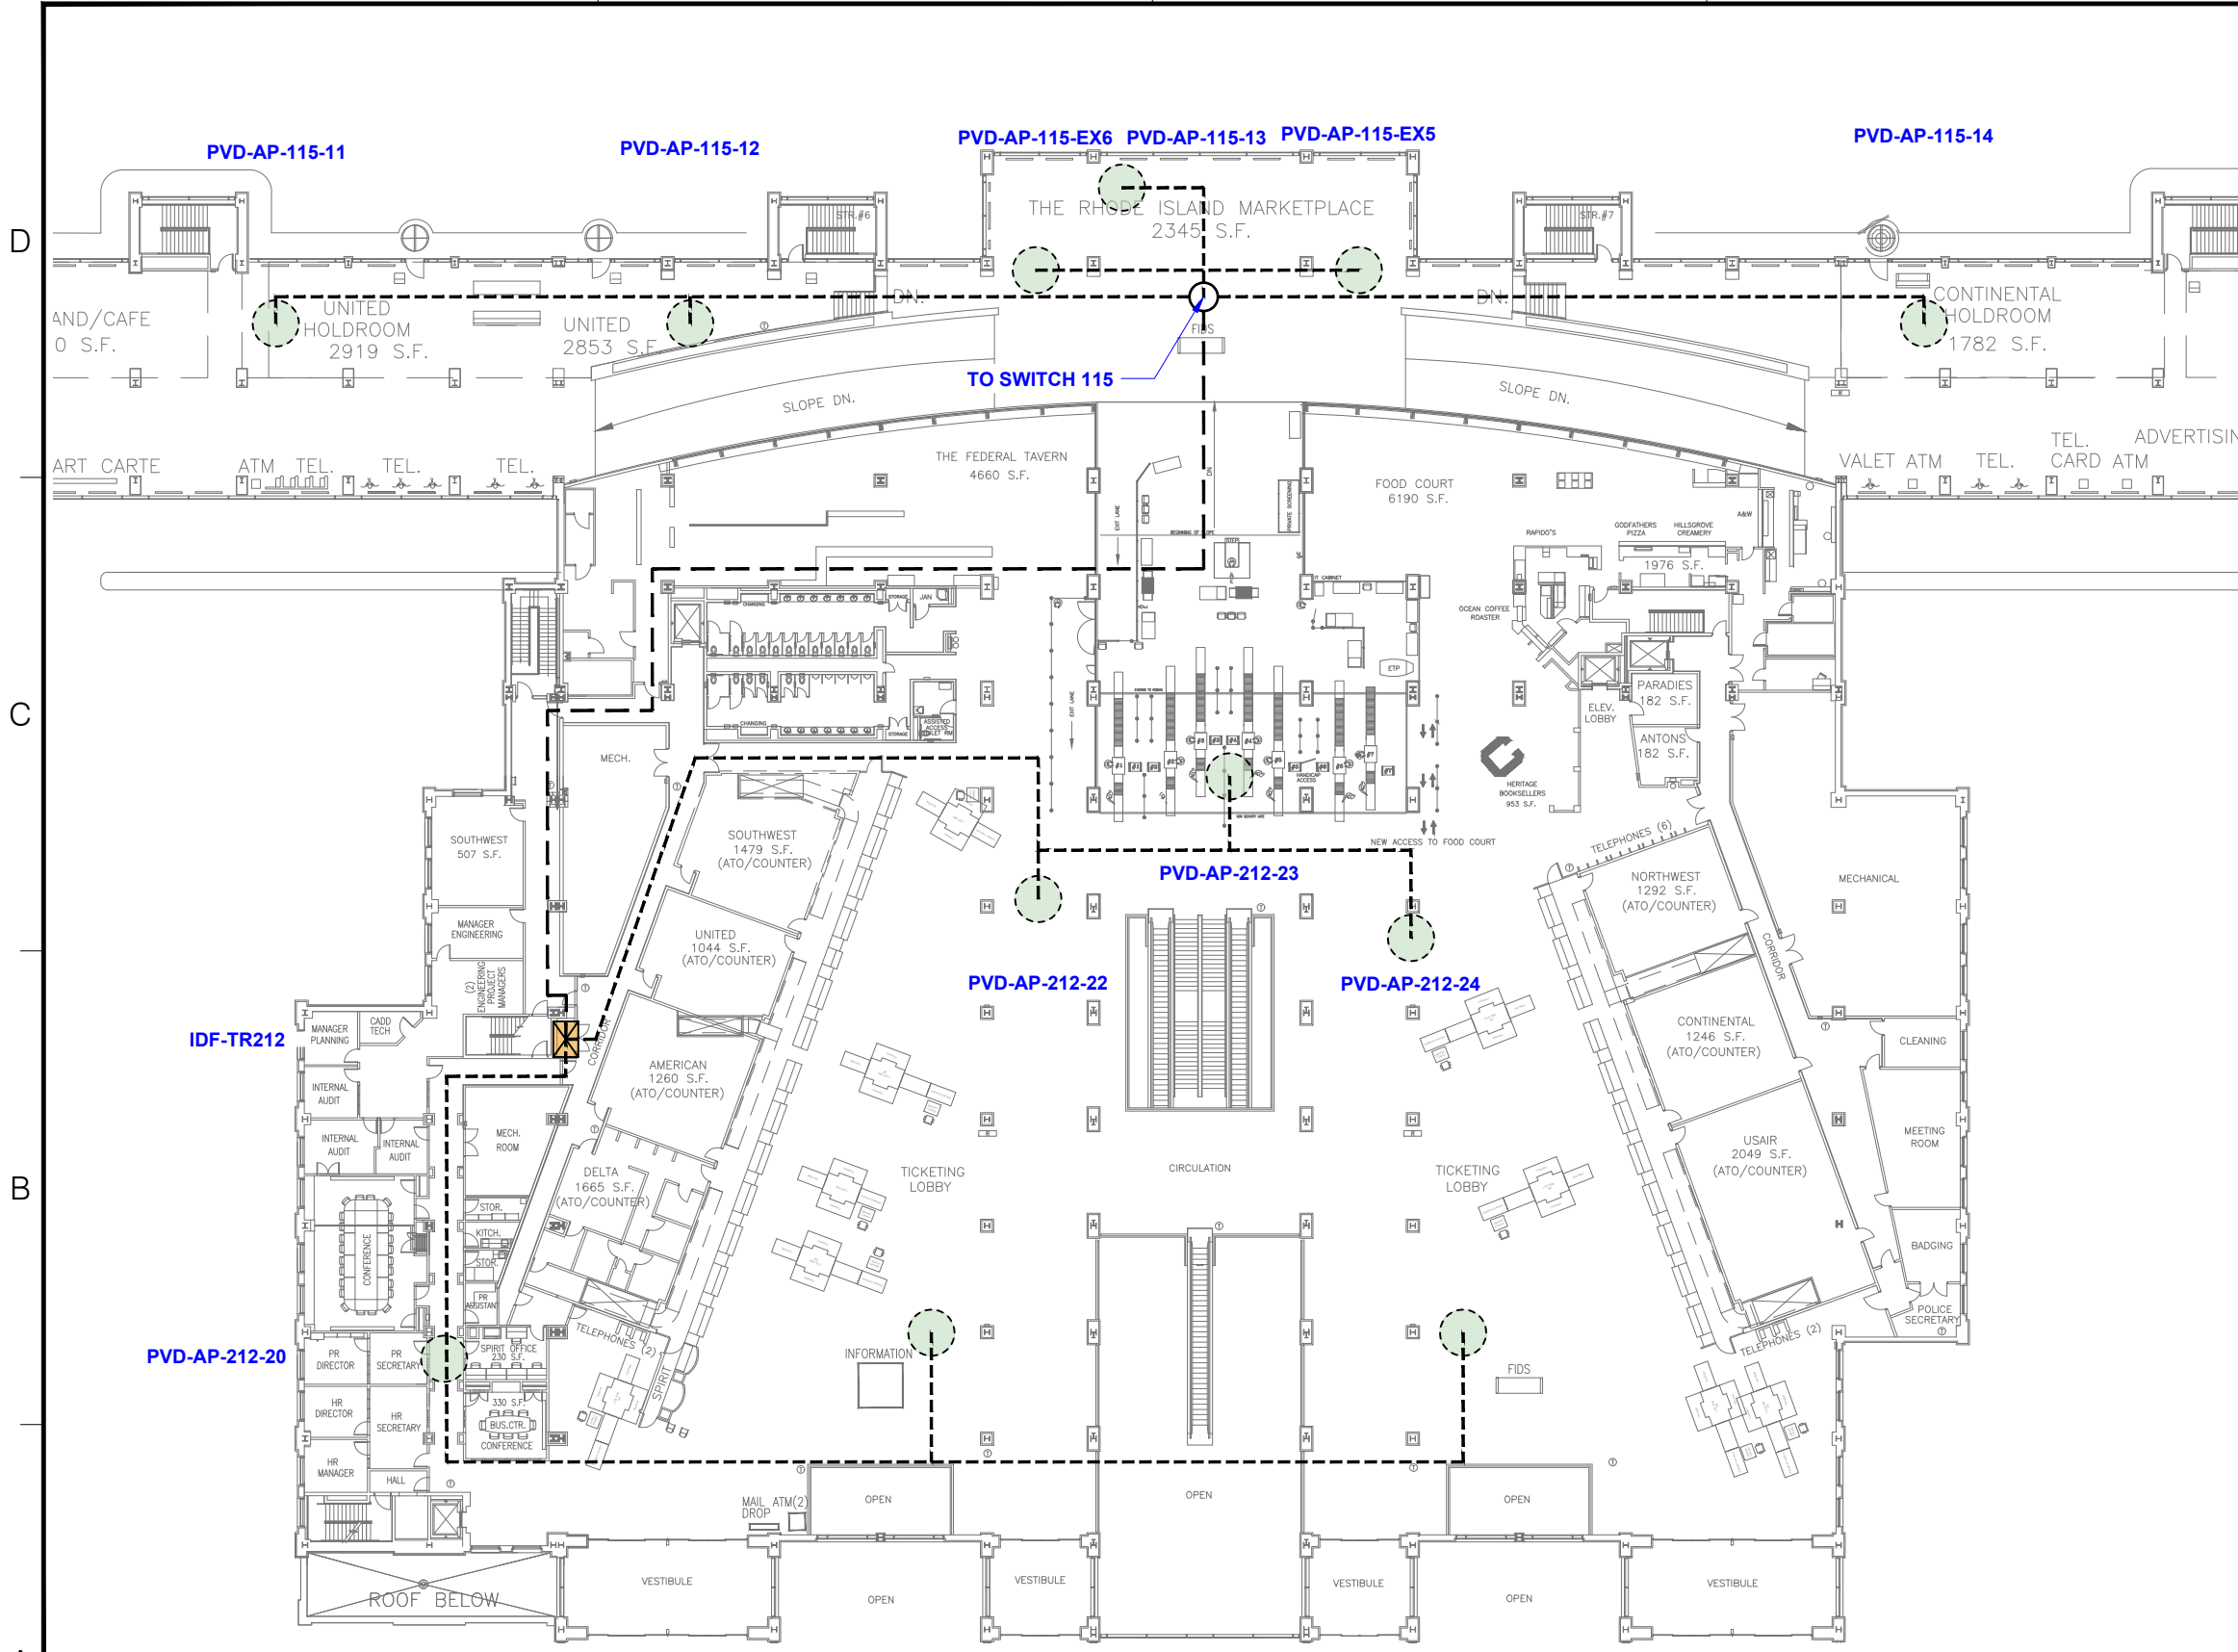

**SECOND FLOOR CENTER CONCOURSE
12 WAP's**

GENERAL NOTES:

- BUILDING TYPE: DROP-CEILING**
 - NEWLY INSTALLED CAT6 WILL BE USED TO CONNECT ALL WAP'S.
 - AP'S TO BE MOUNTED TO DROP CEILING TRACK USING MOUNTING BRACKETS SUPPLIED BY MANUFACTURER. AP'S MAY BE MOVED UP TO TWO TILES (4') IN EITHER DIRECTION IN ORDER TO ACCOUNT FOR CEILING OBSTRUCTIONS SUCH AS LIGHT FIXTURES, EXIT SIGNS, HVAC DUCTS, AND SO FORTH.
- TOTAL WAP QUANTITY: 41
ACCESS POINTS: 10 (1ST FLOOR)
ACCESS POINTS: 31 (2ND FLOOR)
- ALL INDOOR WAP'S ARE CISCO C2702i UNLESS OTHERWISE NOTED.
- PROVIDE 12 VDC POWER TO THE WIRELESS ACCESS POINTS VIA CAT6 SIGNAL CABLE.
- (1) CAT6 CABLE SHALL BE ROUTED TO EACH ACCESS POINT LOCATION.
- IDENTIFY WAP & CAT6 CABLES AS A - B - C - D
WHERE A IS THE SITE ID
WHERE B IS THE ID
WHERE C IS THE SWITCH
WHERE D IS THE WAP

LEGEND:

- WIRELESS ACCESS POINT
- 2-POST RACK OR WALL MOUNT RACK
- CAT6 CABLE PATHWAY FOR ACCESS POINTS AND OUTDOOR BRIDGE RADIOS.
- MULTI-MODE FIBER PATHWAYS
- USE EXISTING VERTICAL CONDUIT SLEEVE OR ADD WHERE REQUIRED BETWEEN FLOORS FOR CABLING TO ROOF / WALL MOUNT BRIDGE RADIOS.

SECOND FLOOR CENTER CONCOURSE - WIRELESS SIGNAL PLAN

SYMBOL	DESCRIPTION	DATE	APPROVED
	AS-BUILT DRAWINGS	2017-05-18	

APPROVED	
----------	--

ACTIVITY	
----------	--

boingo

BOINGO WIRELESS, INC.
10960 WILSHIRE BLVD.
23rd FLOOR
LOS ANGELES, CA, 90024

CAD DESIGNER	EDWARD NARVAEZ
FIELD OPERATIONS MANAGER	DAVID ARMENTO
DIRECTOR	TOM PINCZES

T.F. GREEN AIRPORT (PVD)
WIRELESS SERVICES
WARWICK, RI

SECOND FLOOR CENTER CONCOURSE

SCALE	
PROJECT NO.	000-000
CONSTR. CONTR. NO.	
SHEET	0 OF 00

T1.2B

DRAWING REVISION: 24 May 2017


1

2

3

4

5

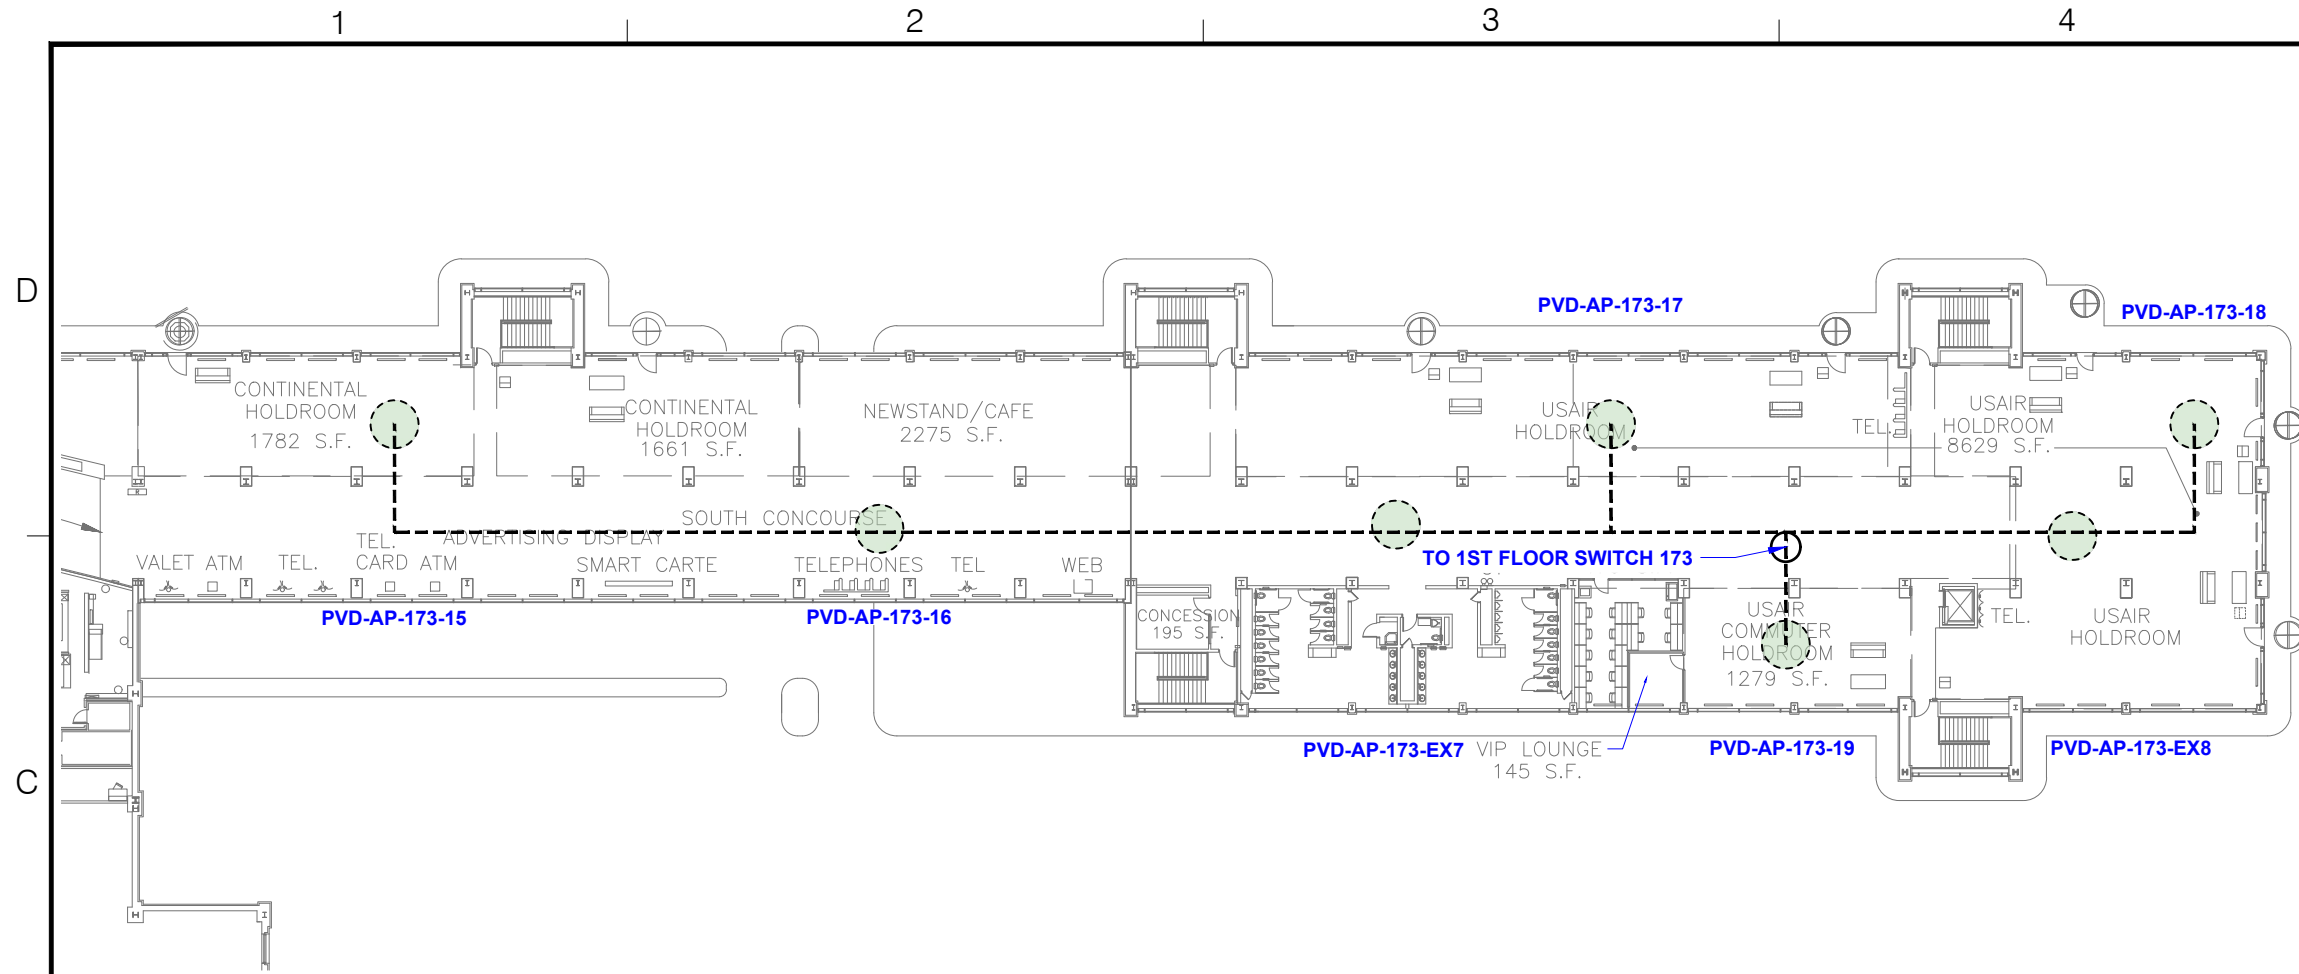

SECOND FLOOR SOUTH CONCOURSE - WIRELESS SIGNAL PLAN

**SECOND FLOOR SOUTH CONCOURSE
7 WAP's**

GENERAL NOTES:

1. BUILDING TYPE: **DROP-CEILING**
 - **NEWLY INSTALLED CAT6 WILL BE USED TO CONNECT ALL WAP'S.**
 - AP'S TO BE MOUNTED TO DROP CEILING TRACK USING MOUNTING BRACKETS SUPPLIED BY MANUFACTURER. AP'S MAY BE MOVED UP TO TWO TILES (4') IN EITHER DIRECTION IN ORDER TO ACCOUNT FOR CEILING OBSTRUCTIONS SUCH AS LIGHT FIXTURES, EXIT SIGNS, HVAC DUCTS, AND SO FORTH.
2. TOTAL WAP QUANTITY: 41
ACCESS POINTS: 10 (1ST FLOOR)
ACCESS POINTS: 31 (2ND FLOOR)
3. ALL INDOOR WAP'S ARE CISCO C2702i UNLESS OTHERWISE NOTED.
4. PROVIDE 12 VDC POWER TO THE WIRELESS ACCESS POINTS VIA CAT6 SIGNAL CABLE.
5. (1) CAT6 CABLE SHALL BE ROUTED TO EACH ACCESS POINT LOCATION.
6. IDENTIFY WAP & CAT6 CABLES AS
A - B - C - D
WHERE A IS THE SITE ID
WHERE B IS THE ID
WHERE C IS THE SWITCH
WHERE D IS THE WAP

LEGEND:

- WIRELESS ACCESS POINT
- 2-POST RACK OR WALL MOUNT RACK
- CAT6 CABLE PATHWAY FOR ACCESS POINTS AND OUTDOOR BRIDGE RADIOS.
- MULTI-MODE FIBER PATHWAYS
- USE EXISTING VERTICAL CONDUIT SLEEVE OR ADD WHERE REQUIRED BETWEEN FLOORS FOR CABLING TO ROOF / WALL MOUNT BRIDGE RADIOS.

SYMBOL DESCRIPTION	AS-BUILT DRAWINGS	DATE	2017-05-18	APPR	
BOINGO WIRELESS, INC. 10960 WILSHIRE BLVD. 23rd FLOOR LOS ANGELES, CA, 90024					
APPROVED					
ACTIVITY					
SATISFACTORY TO DATE					
CAD DESIGNER					
EDWARD NARVAEZ					
FIELD OPERATIONS MANAGER					
DAVID ARMENTO					
DIRECTOR					
TOM PINCZES					
T.F. GREEN AIRPORT (PVD) WIRELESS SERVICES WARWICK, RI			SECOND FLOOR SOUTH CONCOURSE		
SCALE:					
PROJECT NO.: 000-000					
CONSTR. CONTR. NO.:					
SHEET 0 OF 00					
T1.2C					

1

2

3

4

5

1

2

3

4

5

D

D

C

C

B

B

A

A



Rhode Island

Airport Corporation

####END OF ADDENDUM###